
AS BUILT

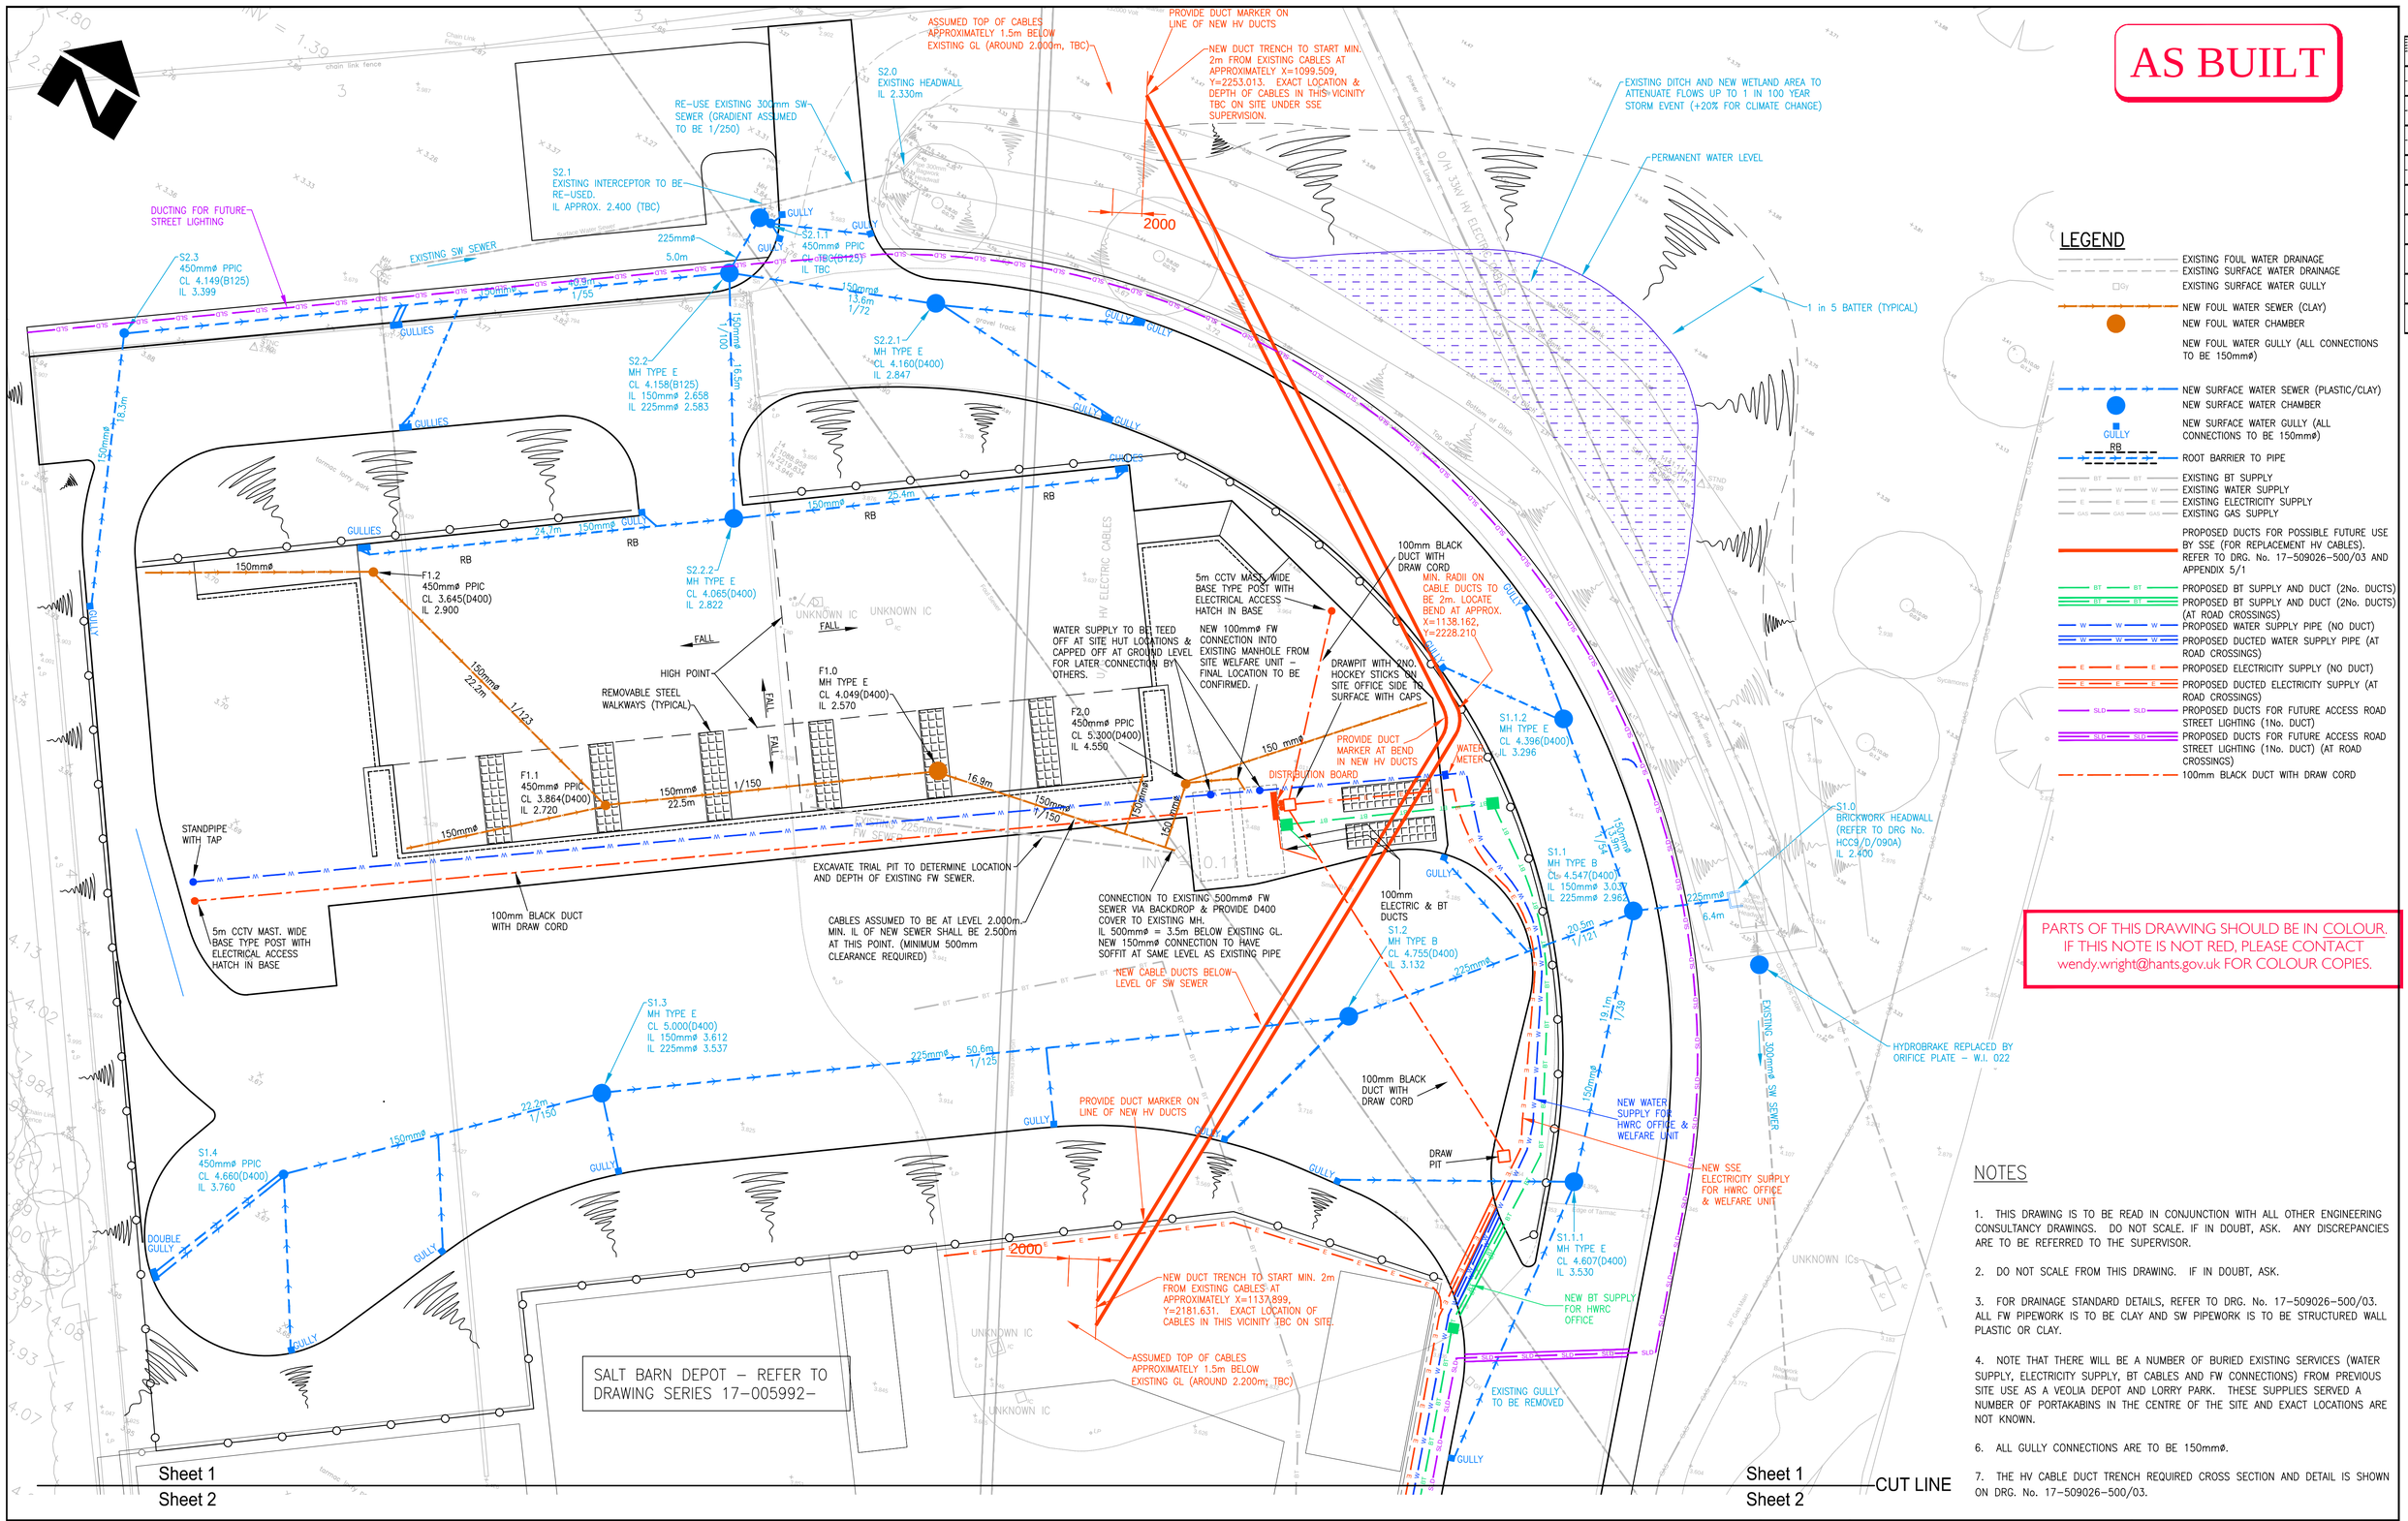

LEGEND

- EXISTING FOUL WATER DRAINAGE
- EXISTING SURFACE WATER DRAINAGE
- EXISTING SURFACE WATER GULLY
- NEW FOUL WATER SEWER (CLAY)
- NEW FOUL WATER CHAMBER
- NEW FOUL WATER GULLY (ALL CONNECTIONS TO BE 150mmø)
- NEW SURFACE WATER SEWER (PLASTIC/CLAY)
- NEW SURFACE WATER CHAMBER
- NEW SURFACE WATER GULLY (ALL CONNECTIONS TO BE 150mmø)
- ROOT BARRIER TO PIPE
- EXISTING BT SUPPLY
- EXISTING WATER SUPPLY
- EXISTING ELECTRICITY SUPPLY
- EXISTING GAS SUPPLY
- PROPOSED DUCTS FOR POSSIBLE FUTURE USE BY SSE (FOR REPLACEMENT HV CABLES). REFER TO DRG. No. 17–509026–500/03 AND APPENDIX 5/1
- PROPOSED BT SUPPLY AND DUCT (2No. DUCTS)
- PROPOSED BT SUPPLY AND DUCT (2No. DUCTS) (AT ROAD CROSSINGS)
- PROPOSED WATER SUPPLY PIPE (NO DUCT)
- PROPOSED DUCTED WATER SUPPLY PIPE (AT ROAD CROSSINGS)
- PROPOSED ELECTRICITY SUPPLY (NO DUCT)
- PROPOSED DUCTED ELECTRICITY SUPPLY (AT ROAD CROSSINGS)
- PROPOSED DUCTS FOR FUTURE ACCESS ROAD STREET LIGHTING (1No. DUCT)
- PROPOSED DUCTS FOR FUTURE ACCESS ROAD STREET LIGHTING (1No. DUCT) (AT ROAD CROSSINGS)
- 100mm BLACK DUCT WITH DRAW CORD

PARTS OF THIS DRAWING SHOULD BE IN COLOUR. IF THIS NOTE IS NOT RED, PLEASE CONTACT wendy.wright@hants.gov.uk FOR COLOUR COPIES.

NOTES

1. THIS DRAWING IS TO BE READ IN CONJUNCTION WITH ALL OTHER ENGINEERING CONSULTANCY DRAWINGS. DO NOT SCALE. IF IN DOUBT, ASK. ANY DISCREPANCIES ARE TO BE REFERRED TO THE SUPERVISOR.
2. DO NOT SCALE FROM THIS DRAWING. IF IN DOUBT, ASK.
3. FOR DRAINAGE STANDARD DETAILS, REFER TO DRG. No. 17–509026–500/03. ALL FW PIPEWORK IS TO BE CLAY AND SW PIPEWORK IS TO BE STRUCTURED WALL PLASTIC OR CLAY.
4. NOTE THAT THERE WILL BE A NUMBER OF BURIED EXISTING SERVICES (WATER SUPPLY, ELECTRICITY SUPPLY, BT CABLES AND FW CONNECTIONS) FROM PREVIOUS SITE USE AS A VEOLIA DEPOT AND LORRY PARK. THESE SUPPLIES SERVED A NUMBER OF PORTAKABINS IN THE CENTRE OF THE SITE AND EXACT LOCATIONS ARE NOT KNOWN.
6. ALL GULLY CONNECTIONS ARE TO BE 150mmø.
7. THE HV CABLE DUCT TRENCH REQUIRED CROSS SECTION AND DETAIL IS SHOWN ON DRG. No. 17–509026–500/03.

REV	AMENDMENTS	DATE	CAD	CHKD	APPD
A	ISSUED AS BUILT	06.12.2016	SCL		

CLIENT

HAMPSHIRE COUNTY COUNCIL
ECONOMY, TRANSPORT & ENVIRONMENT
WASTE & RESOURCE MANAGEMENT

CONSULTANT

Hampshire County Council Engineering CONSULTANCY

STUART JARVIS BSc DipTP FCIHT MRTPI: DIRECTOR OF ECONOMY, TRANSPORT & ENVIRONMENT

DESIGNER	WHW
CAD	WHW
CHECKED	SRF | SRF
APPROVED	DD | DD

SCHEME: HAVANT INCINERATOR SITE REDEVELOPMENT
JOB No. R.J509026.01

DRAWING TITLE: RELOCATION OF HAVANT HWRC SW & FW DRAINAGE SYSTEMS AND PROPOSED UTILITIES
HCC CAD PLOT: 07/12/2016 12:42:09

SCALE @ A1	DATE	SHEET NUMBER	DRAWING NUMBER	REV
1:200	OCT 10	1 OF 2	17-509026-500/01	A

HCC CAD FILE: K:\Engl\Roads\Schemes\RJ509026 Havant HWRC\AutoCAD\Contract Drawings Revised-HWRC\AS BUILTS\17-509026-500-01-02-03 REV A.dwg